


2ND FLOOR PLAN


SCALE: 1/16"=1'-0"



NORTH

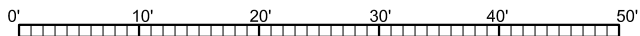

GRAPHIC SCALE: FEET

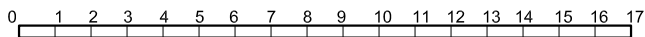

GRAPHIC SCALE: YARDS

**FRANCIS PALMS
BUILDING**

2111 Woodward Ave.
Detroit, MI 48201

Owner: *Palms State LLC*

DESCRIPTION

2ND FLOOR PLAN - AS-BUILT

DATE: 10-5-23