



**6TH FLOOR PLAN**

SCALE: 1/16"=1'-0"

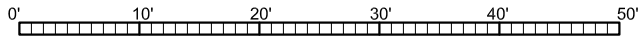

GRAPHIC SCALE: FEET

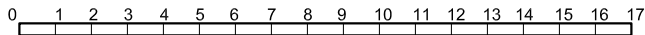

GRAPHIC SCALE: YARDS

**FRANCIS PALMS  
BUILDING**

2111 Woodward Ave.  
Detroit, MI 48201  
Owner: *Palms State LLC*

DESCRIPTION  
6TH FLOOR PLAN - AS-BUILT  
3,128 sq ft

DATE: 10-05-23